

Week 14 Meeting



12/03/18

Team Leader: Nur

Other Team Members: Katayi, Ahmed, Chufu, Tam, YJ

Advisor: Dr. Ajjarapu

Safety Moment:


To avoid trips, slips, and falls during winter:

1. Keep walkways, stairways and other work areas clear.
2. Remove hazards, such as water on floors and snow on sidewalks, immediately.
3. When walking, look where you are going and have your hands ready to steady yourself should you slip.
4. Avoid carrying heavy loads that may compromise your balance.
5. Mark hazardous areas. Use temporary signs, cones, barricades or floor stands to warn passing workers.
6. Outside, wear footwear with heavy treads for increased traction. Walk along grassy areas if a walkway is covered in ice. Make yourself visible to drivers by wearing a brightly colored jacket or clothes.

Topics

- AC1 and AC2 diagram questions.

A B C D E F G H I J K L M N O P Q R S T

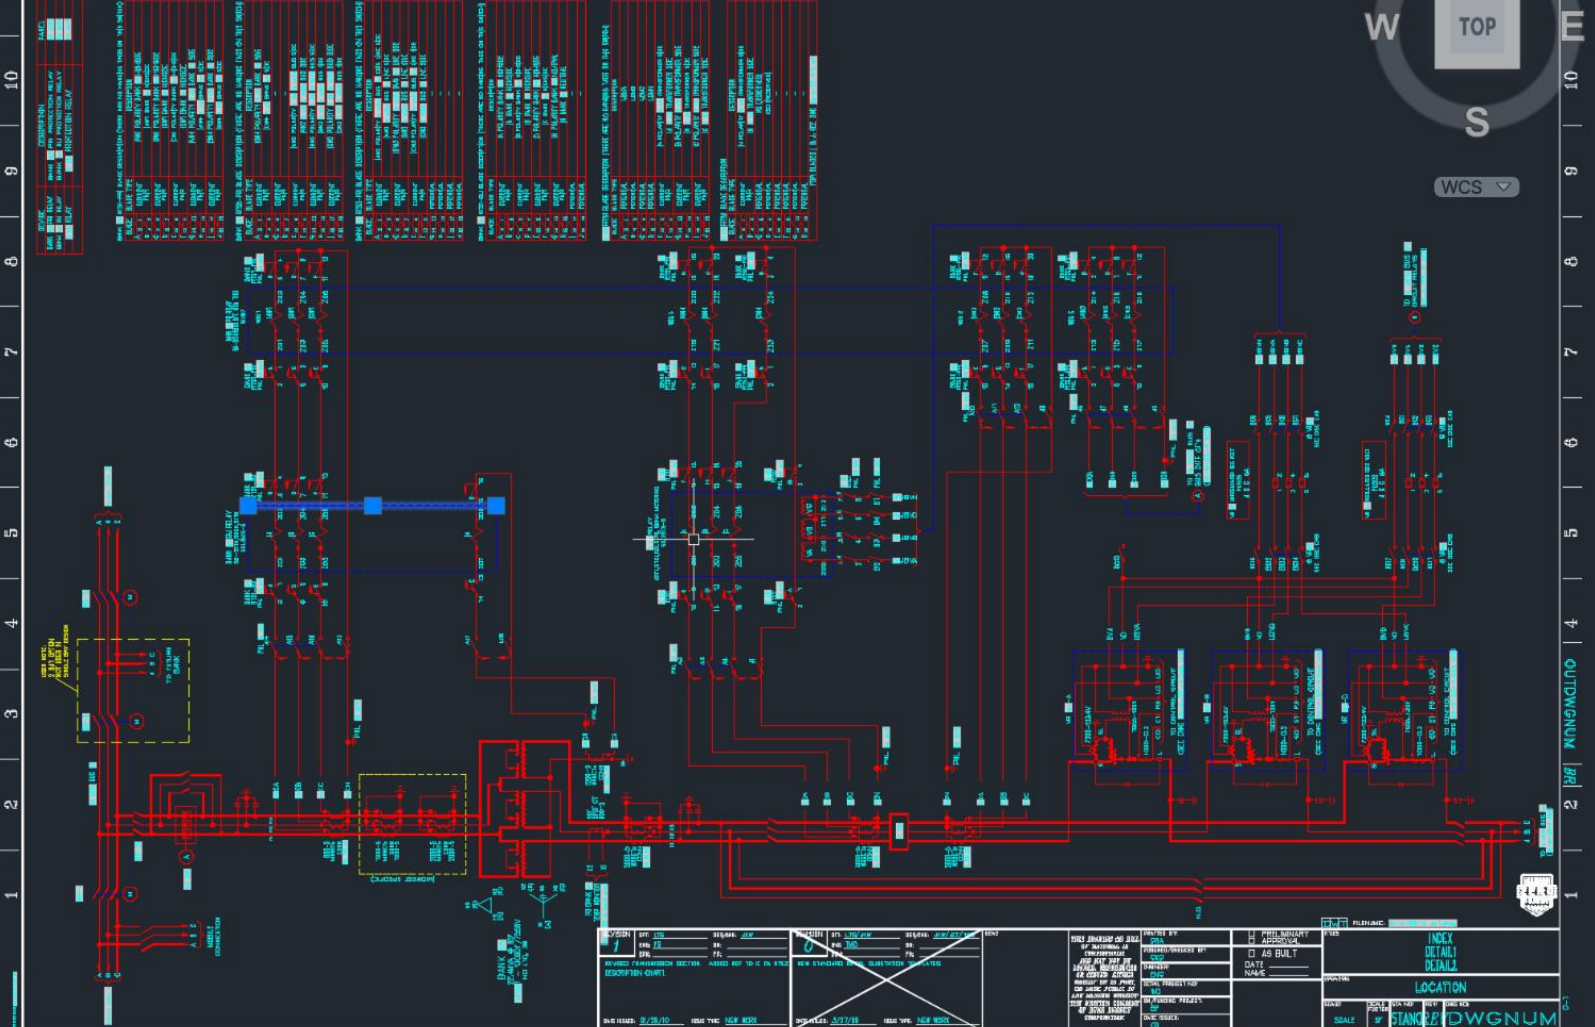












INDEX

AS BUILT

DATE: 8/26/10

LOCATION: STANLEY DWGNUM



TOP

S

WCS

A B C D E F G H I J K L M N O P Q R S T

1 2 3 4 5 6 7 8 9 10 11


OUTDWGNUM

AC1 Diagram


What is the purpose of ac1 and ac2?


What is the function of this connection ?

Is the A a measuring device?

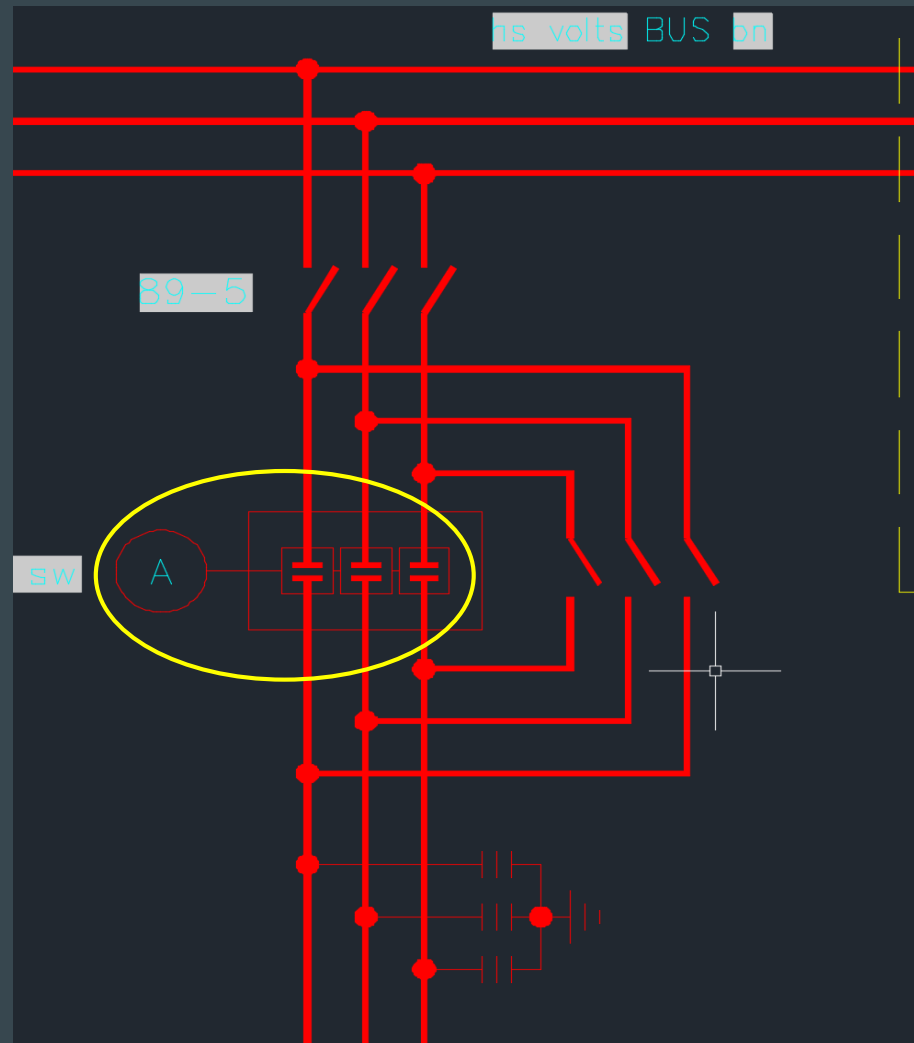


What is the single bay design?

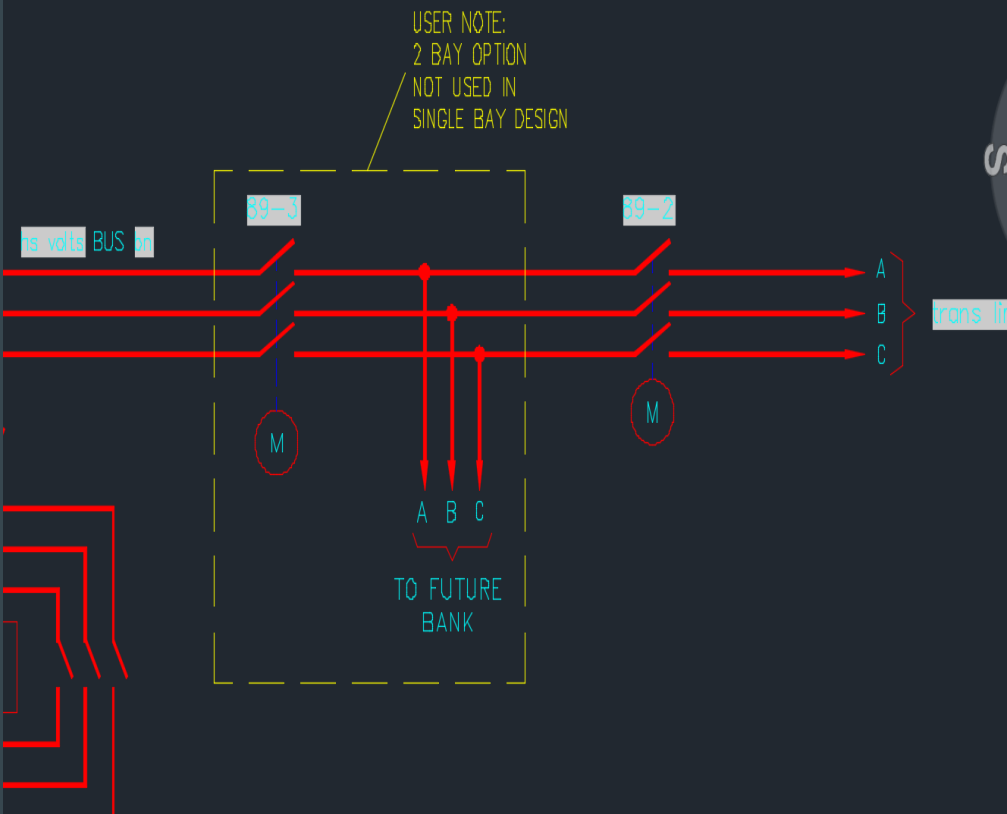

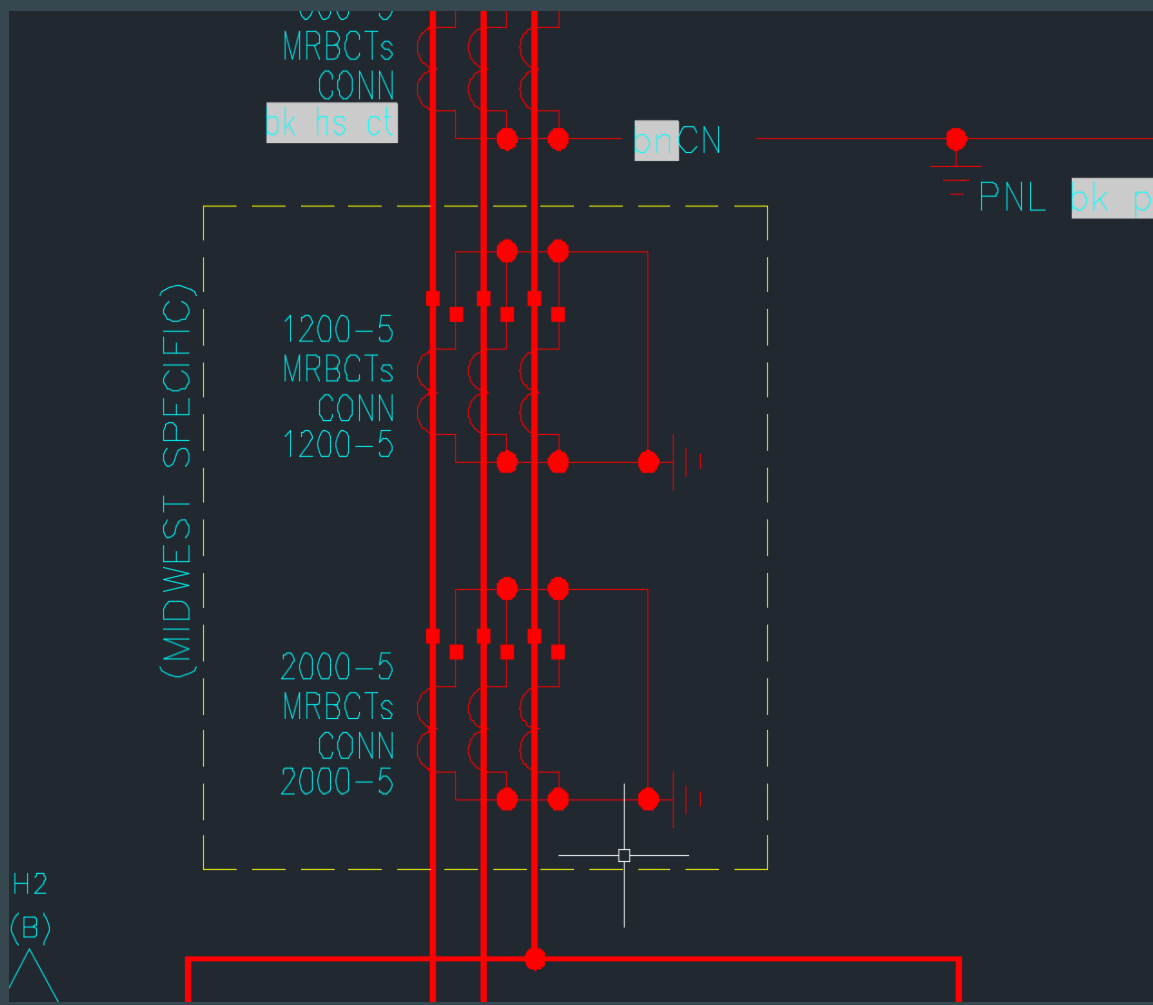

What drawing does this control connected to?
(a1 states that it is connected to ds-s-22-4 bus vr (a b or c))

What does this control do?

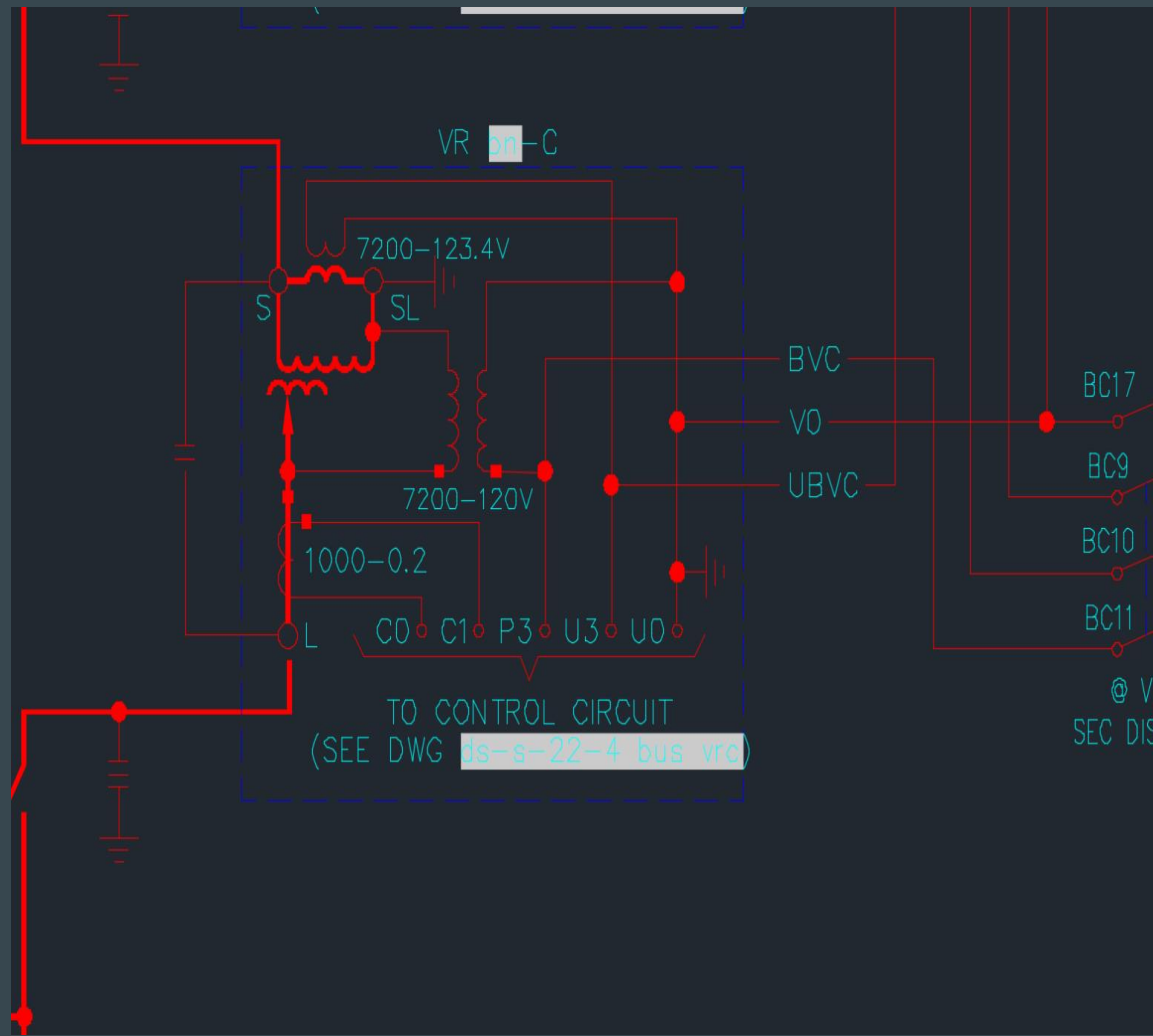


Is this a voltage regulator and if so
are going to delete it since we didn't
use one in the Key protection ?



AC2 Diagram


Should we delete the transfer bus?

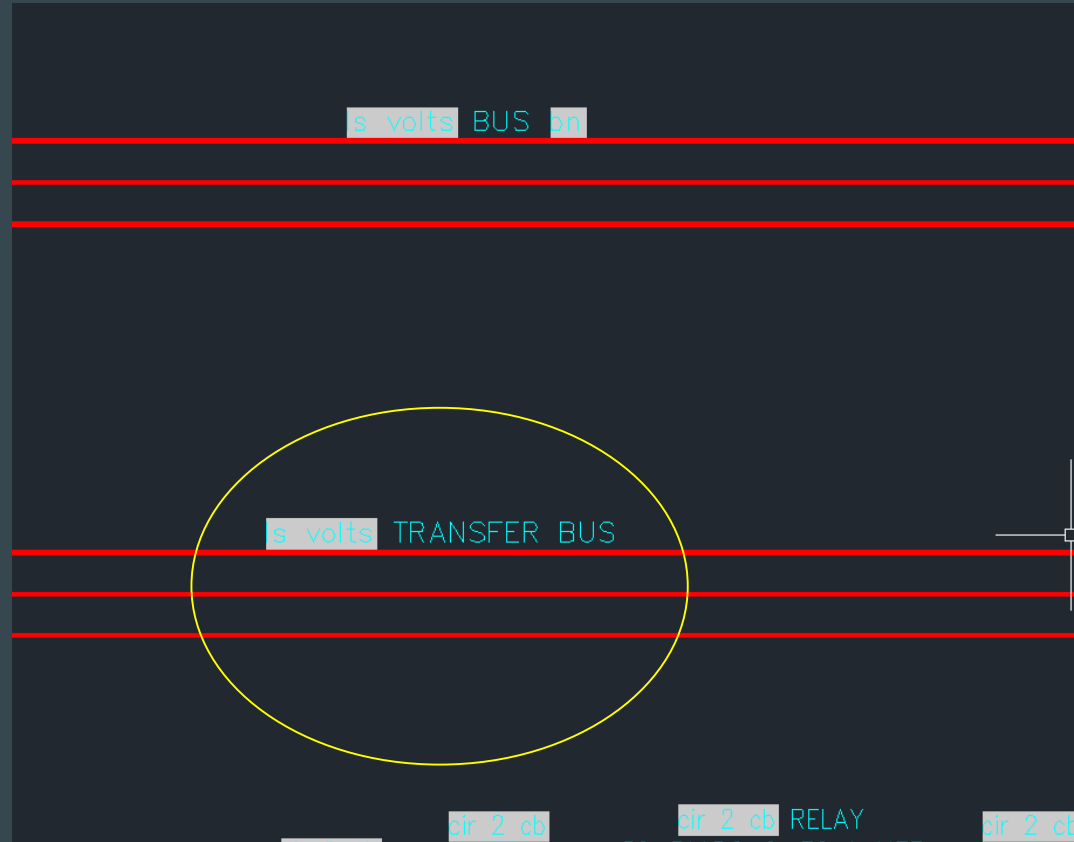

Is this the inside of the relay?



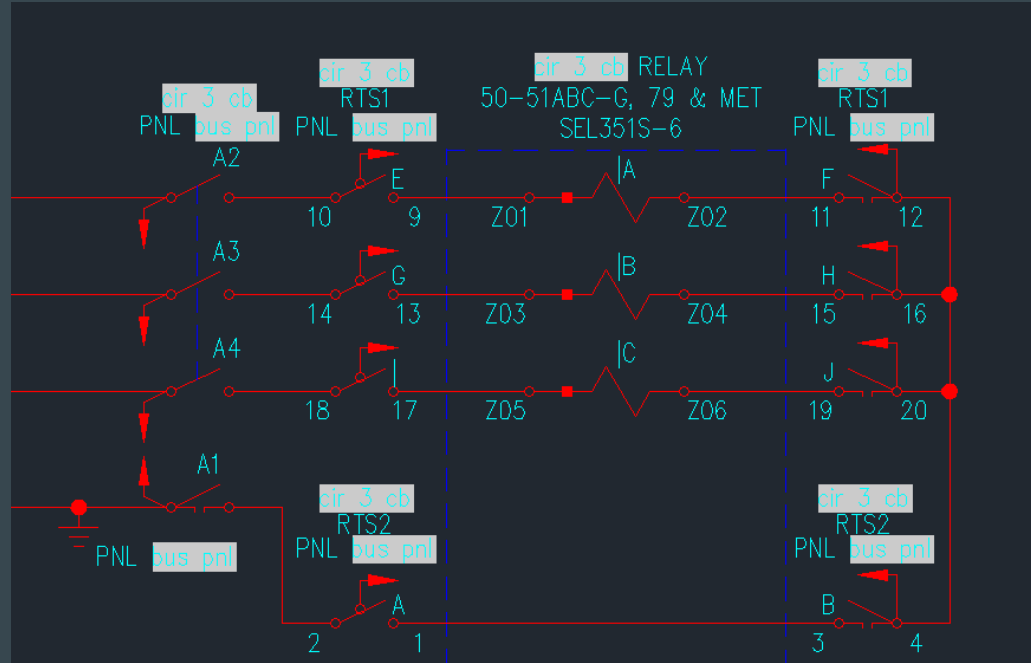


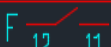
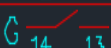
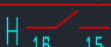
What is going on inside this connection?

How do we check the terminals of the bu relay in this drawing?



What is the blade description?

1 cb RTS2 BLADE DESCRIPTION


BLADE	BLADE TYPE	DESCRIPTION
A 	CURRENT PAIR	N POLARITY 1 cb TRANSFORMER SIDE
B 		N 1 cb TRANSFORMER SIDE
C 	POTENTIAL	V5 {RESERVED}
D 	POTENTIAL	VSD {RESERVED}
E 	POTENTIAL	-
F 	POTENTIAL	-
G 	POTENTIAL	-
H 	POTENTIAL	-

FOR BLADES | & J, SEE DWG ds-s-22-4 1t rel



What exactly is this and how does it work?

Why does it only connect one phase?

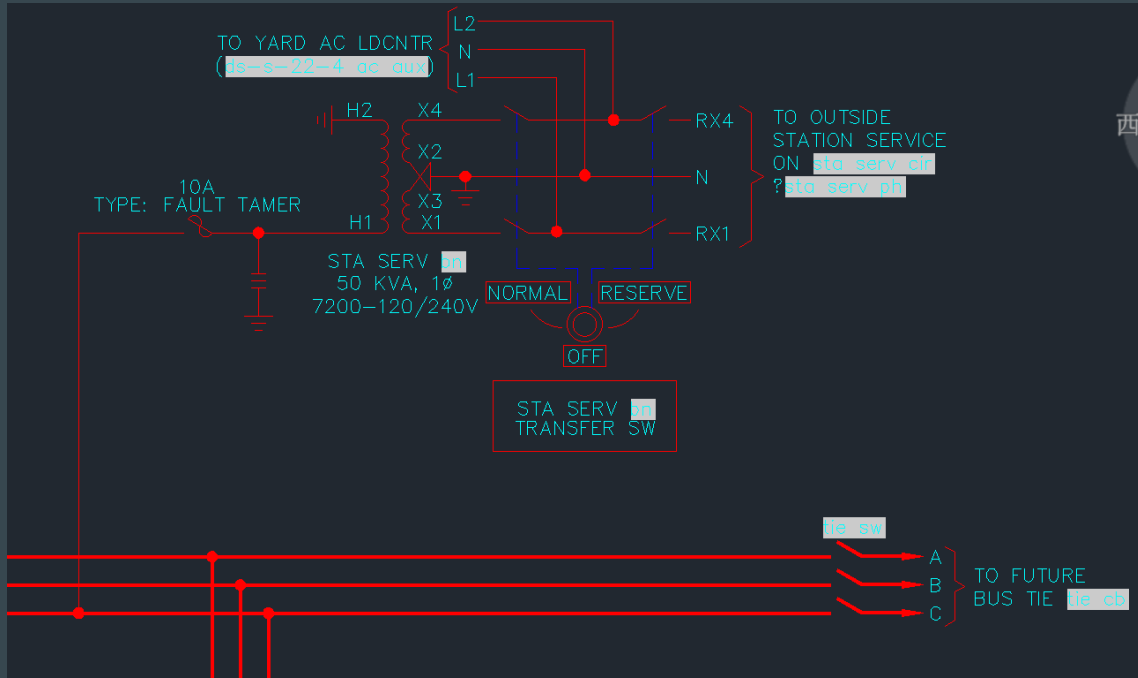

Question

Do you have any software or simulator to test the solar plant and substation?

Can you give a little more info on the man-hour budget? What is the dollar amount per hour?